


SUITE 520 SPACE PLAN
2,349 rsf

PROJECT: _____
 PROJ. NO: _____
 SCALE: 1/8"=1'-0"
 ISSUE DATE: 3/6/2024
 REF DWG: _____
 DWG. NO: SP3-620


LEOTTA DESIGNERS INC
 75 VALENCIA AVENUE., SUITE 302, CORAL GABLES, FL. 33134 PH:(305)371.4949 FAX:(305)371.2844

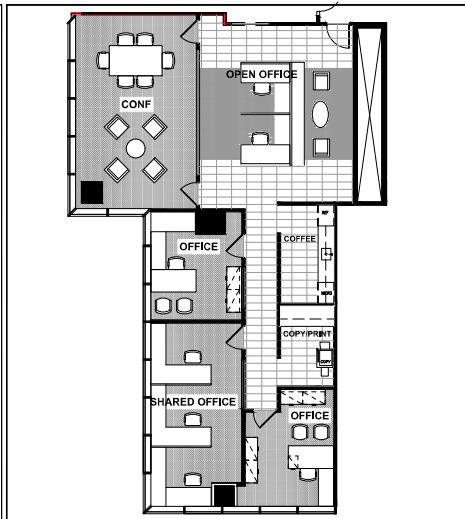

SUITE 520 SPACE PLAN
2,349 rsf

PROJECT: _____
 PROJ. NO: _____
 SCALE: 1/8"=1'-0"
 ISSUE DATE: 3/6/2024
 REF DWG: _____
 DWG. NO: SP2-620


LEOTTA DESIGNERS INC
 75 VALENCIA AVENUE., SUITE 302, CORAL GABLES, FL. 33134 PH:(305)371.4949 FAX:(305)371.2844

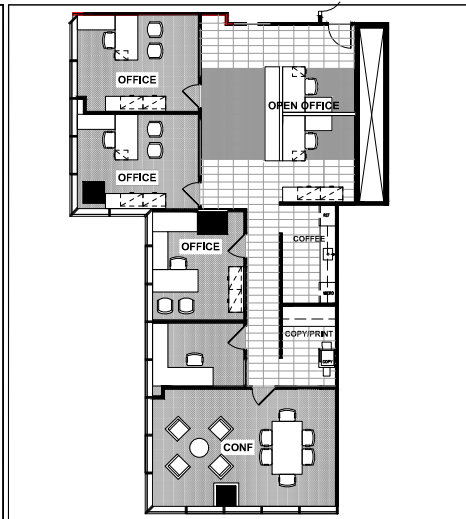

SUITE 520 SPACE PLAN
2,349 rsf

PROJECT: _____
 PROJ. NO: _____
 SCALE: 1/8"=1'-0"
 ISSUE DATE: 3/6/2024
 REF DWG: _____
 DWG. NO: SP1-620

LEOTTA DESIGNERS INC
 75 VALENCIA AVENUE., SUITE 302, CORAL GABLES, FL. 33134 PH:(305)371.4949 FAX:(305)371.2844

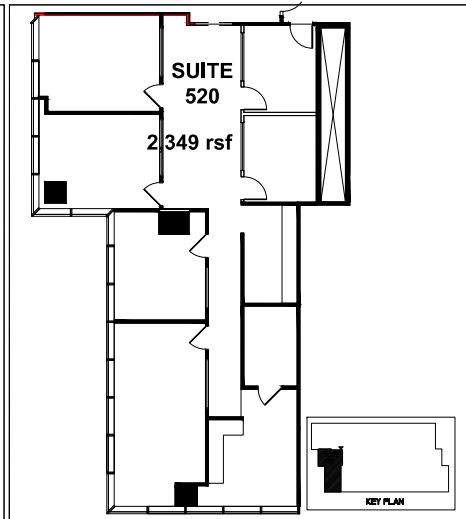

SUITE 520 AS BUILT PLAN
2,349 rsf

PROJECT: _____
 PROJ. NO: _____
 SCALE: 1/8"=1'-0"
 ISSUE DATE: 3/6/2024
 REF DWG: _____
 DWG. NO: AB-620

LEOTTA DESIGNERS INC
 75 VALENCIA AVENUE., SUITE 302, CORAL GABLES, FL. 33134 PH:(305)371.4949 FAX:(305)371.2844